

ELMER NORTH
FARM

T&R DRAINAGE INC.

GLENN REUTER II

683-2586

GARY TESKE

{217}394-2400



Dora Schumacher

Onarga Twp. Sec. 4


1"=400'

North Place

South Side

~~"S" "S"~~

~~South Side~~

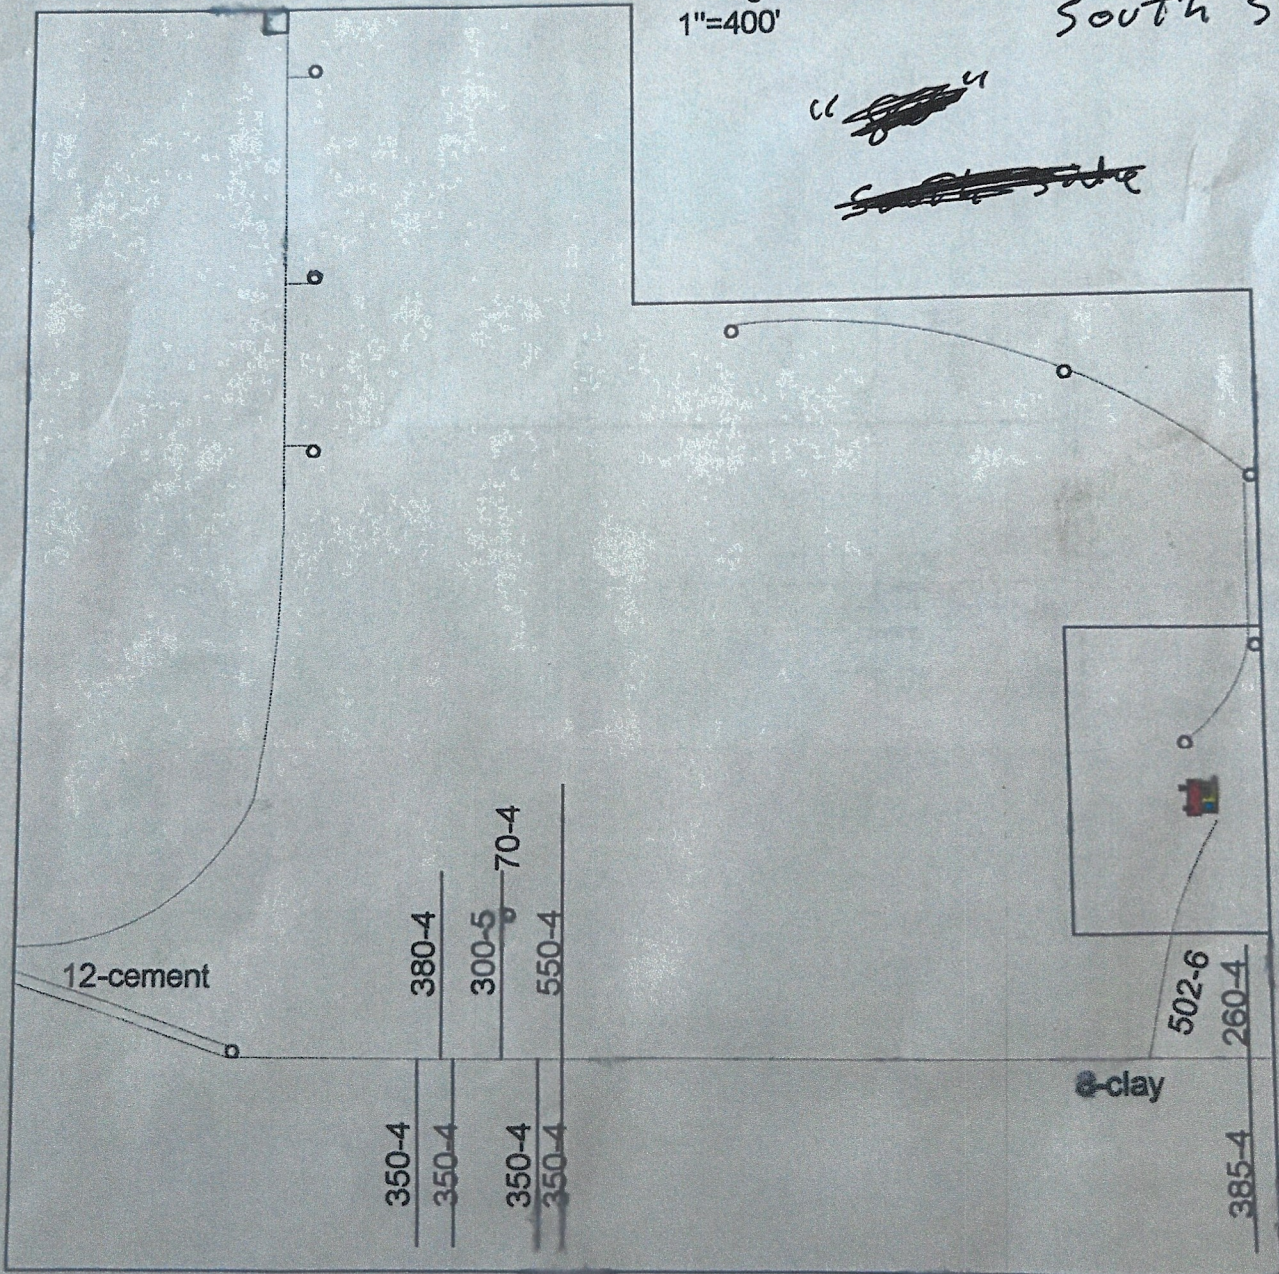

Mom's North Place
3-22-2002

Ralph Henrichs

[illegible]

5. Property line

6" CLAY
1/2 FOUR OF
ONE

Buildings
and house

Rd. 1000 E.

442'-y



M^o Gee

199'
410' 8" Plastic tile

starting point

830'

350'-4"-P

350'-4"-P

350'-4"-P

350'-4"-P

124'

380'-4"-P

196'

5" cement

196'

196'

8" Plastic 410'


KITN

Ralph Humick

Schumacher, D.
2400'-4"- Plastic
300'-5"- Plastics

200' N

Sept-23-1983

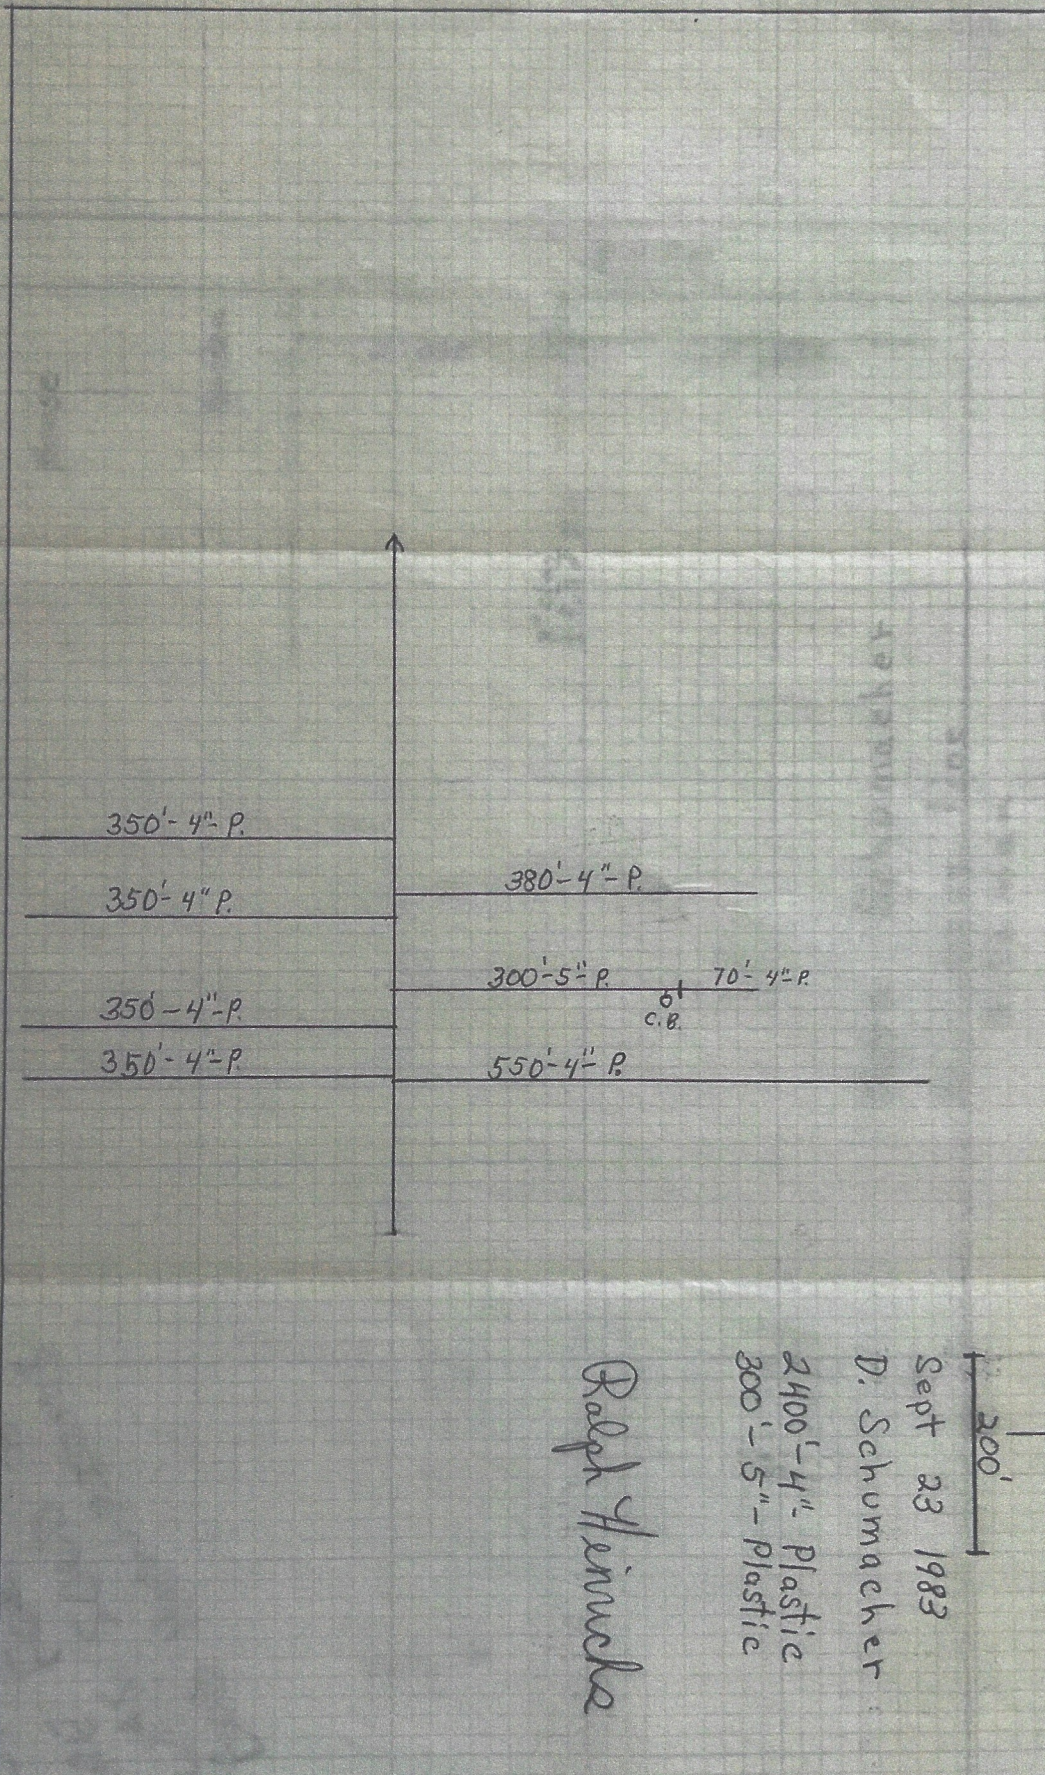

N
200'

Sept 23 1983

D. Schumacher

2400'-4"- Plastic
300'-5"- Plastic

Ralph Heinicke